


KIDNEY HILL PARK  
 AS BUILT SURVEY JOINTLY CONDUCTED WITH  
 KMC LAND, SHEHRI AND DISTRICT ADMINISTRATION (EAST)  
 DATE: FEB. 26, 2020

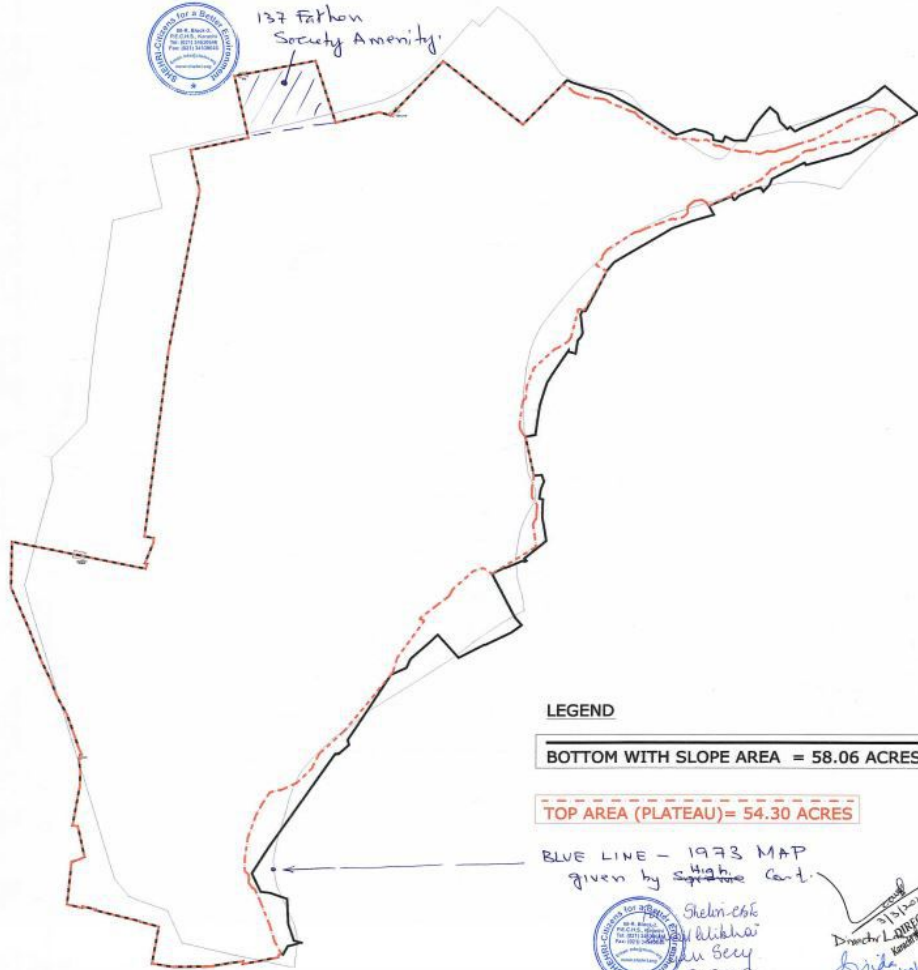

**LEGEND**

**BOTTOM WITH SLOPE AREA = 58.06 ACRES**

**TOP AREA (PLATEAU) = 54.30 ACRES**

BLUE LINE - 1973 MAP  
 given by High Court.



Shelin-est  
 Alkha  
 Sany  
 3-3-2020

Director LAND  
 District Administration  
 East  
 Assistant Commissioner &  
 Special Magistrate  
 Ferrozshah

**KIDNEY HILL JOINT SURVEY AND DEMARCATION UNDER THE SUPERVISION OF THE DISTRICT  
 ADMINISTRATION (EAST)+KMC LAND DEPARTMENT AND SHEHRI.CBE  
 FROM DATED. 24.02.2020 TO DATED. 27.02.2020**



- Legend**
- Kidney Hill (As Built 56.26 Acre & 6.34 Acre Encroachment Area)
  - AS PER 1973 AGREED UPON BY ALL PARTIES
  - Kidney Hill Park as per 1973 MAP
  - Encroachment as per 1973 MAP
  - KWSB Water Reservoir
  - Masjid
  - Mazar, Masjid & Alam

Director LAND  
 District Administration  
 East  
 Assistant Commissioner &  
 Special Magistrate  
 Ferrozshah